


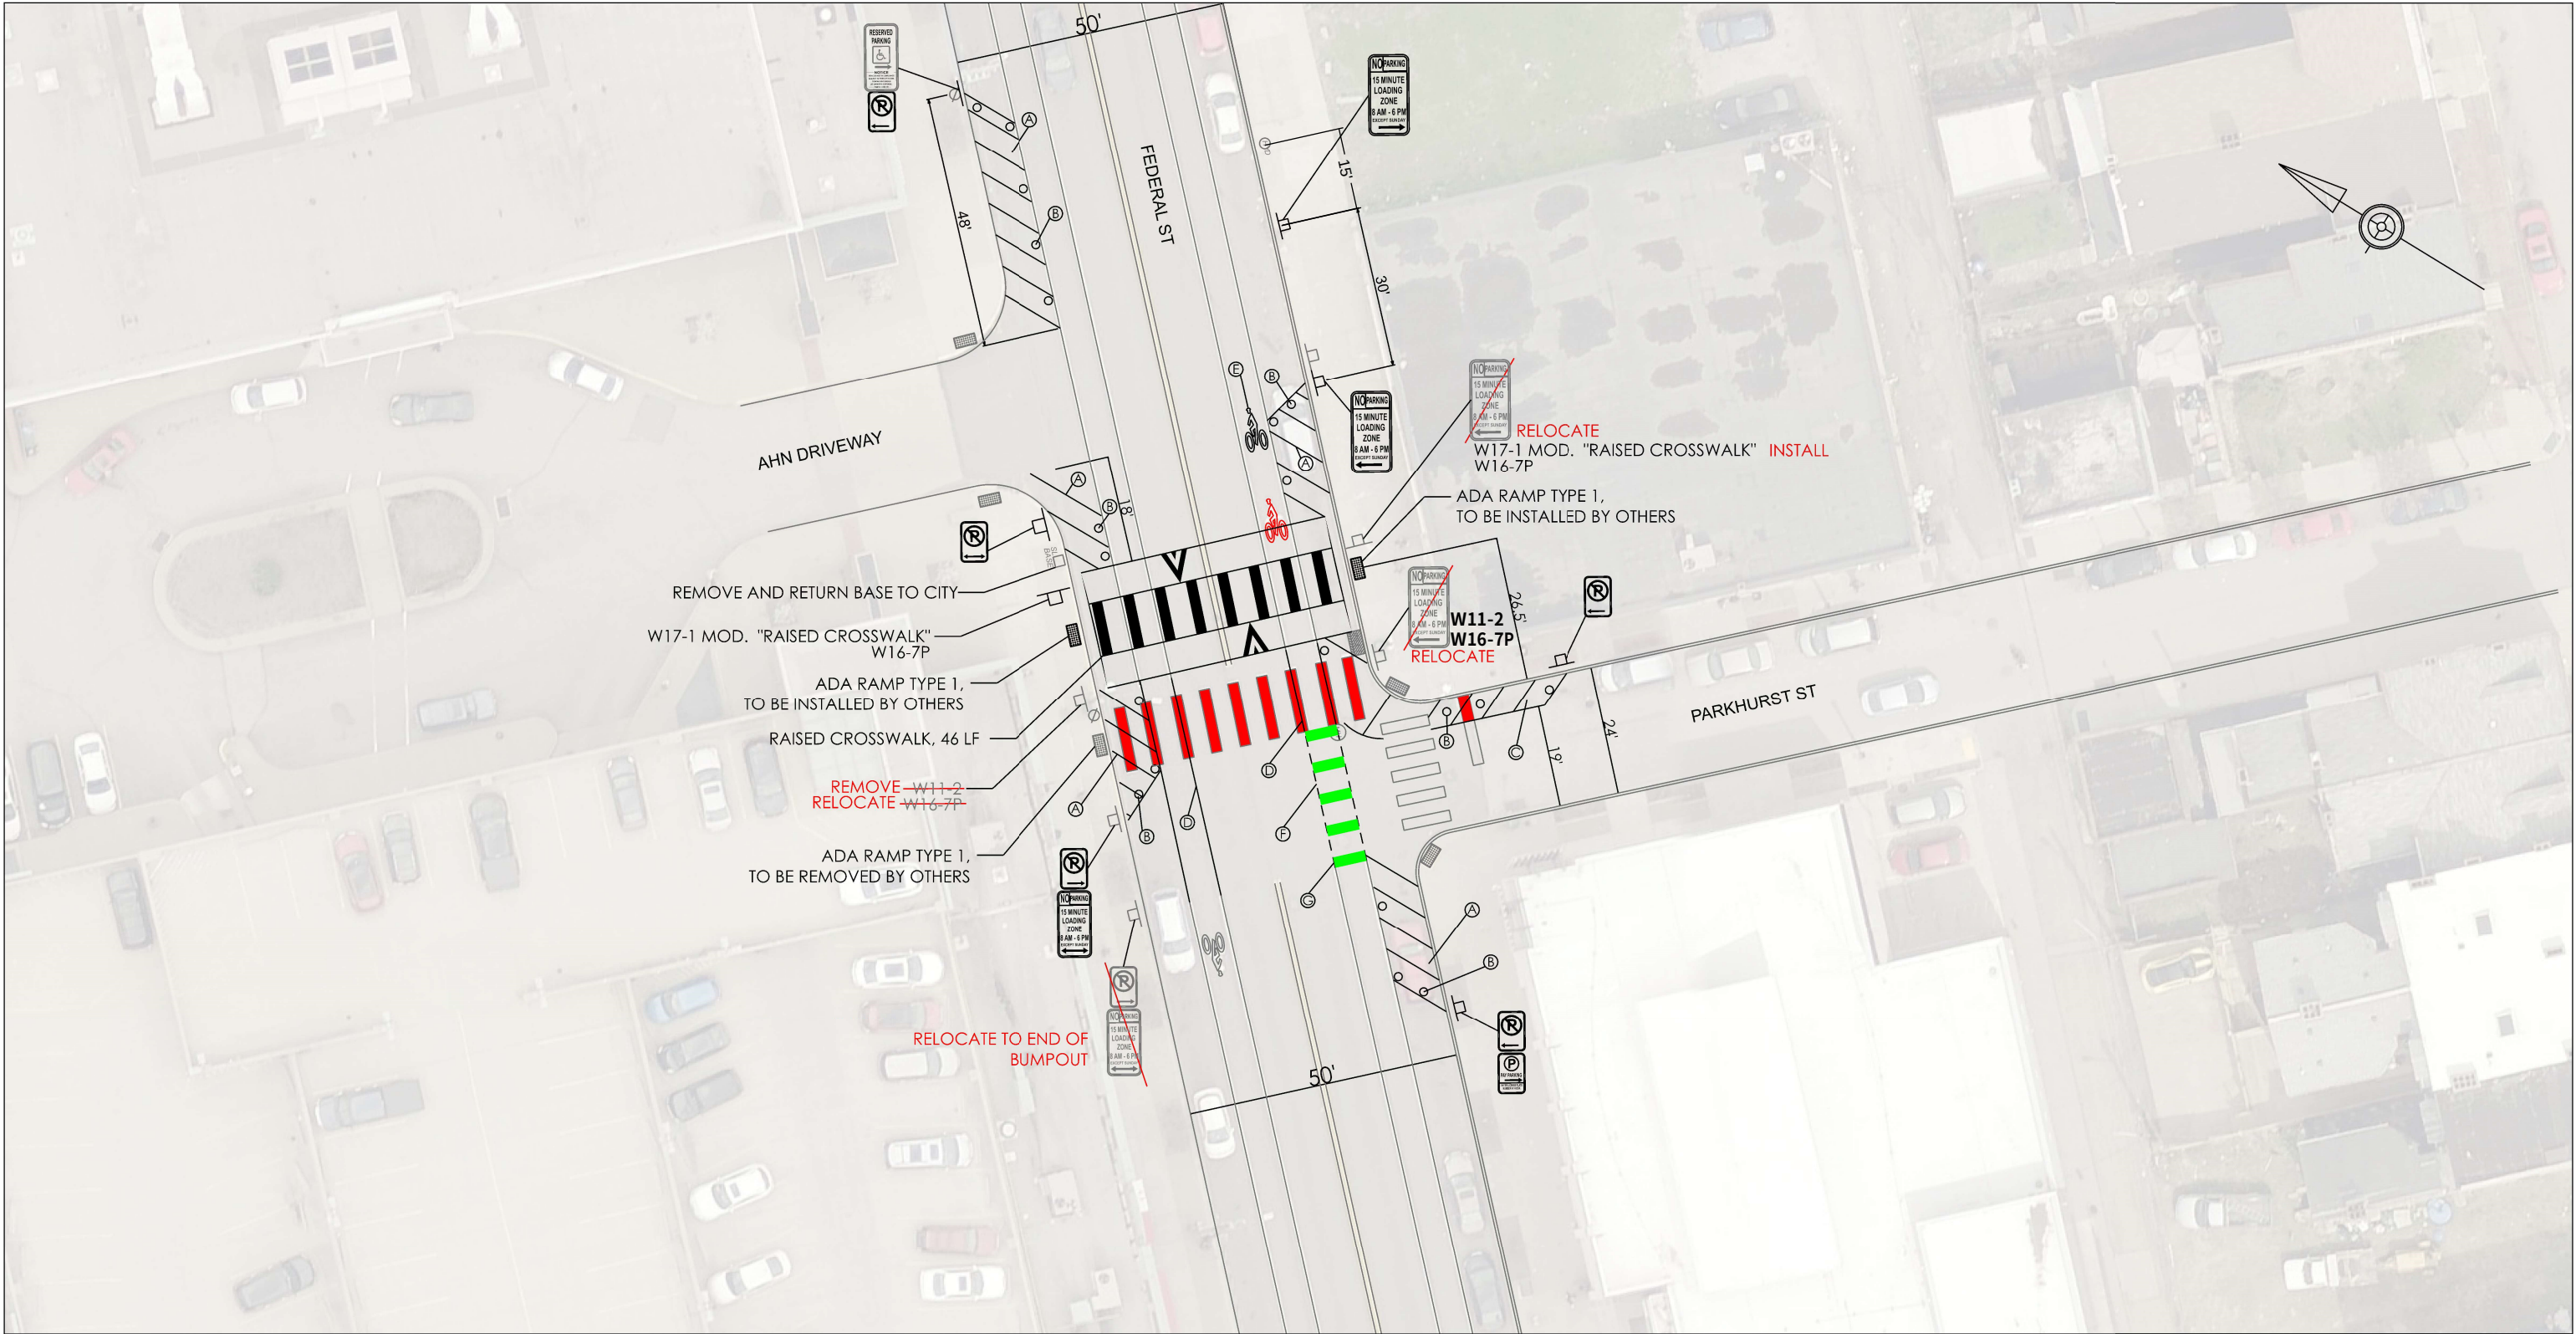

GENERAL NOTES:

ERADICATE MARKINGS SHOWN IN RED

- Ⓐ INSTALL 8' NO PARKING BUMPOUT: INNER GORE: W/6" , 6' O.C., OUTER EDGE: W/6" 25' FROM E.O.C., UNLESS OTHERWISE NOTED
- Ⓑ 36" FLX POSTS WHITE, 1' OFFSET FROM OUTER EDGE, PLACED AS SHOWN
- Ⓒ INSTALL 5' NO PARKING BUMPOUT: INNER GORE: W/6" , 6' O.C., OUTER EDGE: W/6" 25' FROM E.O.C., UNLESS OTHERWISE NOTED
- Ⓓ W/6"
- Ⓔ BIKE RIDER
- Ⓕ W/6" DASH

Ⓒ 24" GREEN MMA PIANO KEYS, 6' SPACING, O.C.

DATE OF REVISION	MADE BY	CHECKED BY	DESCRIPTION

APPROVED BY DATE

KMT 05/12/2025

DRAWN BY

S.A. Stephens 6/5/2025

REVIEWED BY

Mark P. Mc 06/06/2025

CITY OF PITTSBURGH
DEPARTMENT OF MOBILITY
AND INFRASTRUCTURE
TRAFFIC ENGINEERING DIVISION

**FEDERAL ST
AT PARKHURST ST**

TRAFFIC SAFETY IMPROVEMENT
PLAN

SCALE: 1:30
DATE: 05/12/2025

SHEET NO.
1 OF 1